


FOLIO NUMBER	DATE OF APPLICATION (Y/M/D) <i>2005, 04, 25</i>	NAME OF OWNER <i>Wolfgang Krist</i>	NAME OF CONTRACTOR <i>Peter Rampsberger</i>
--------------	--	--	--

LEGAL DESCRIPTION OF LOT <i>Lot 10, Plan 9419, D.L. 3922 A</i>	STREET ADDRESS / GENERAL LOCATION <i>3561 Camlin Hendrix Lk RD, Eagle Creek</i>
INSTALLED AS PER REGULATIONS ☒ Yes ☐ No SIGNATURE OF OWNER / APPLICANT <i>Wolfgang Krist</i>	

AS BUILT DIAGRAM : to be completed by the contractor or applicant

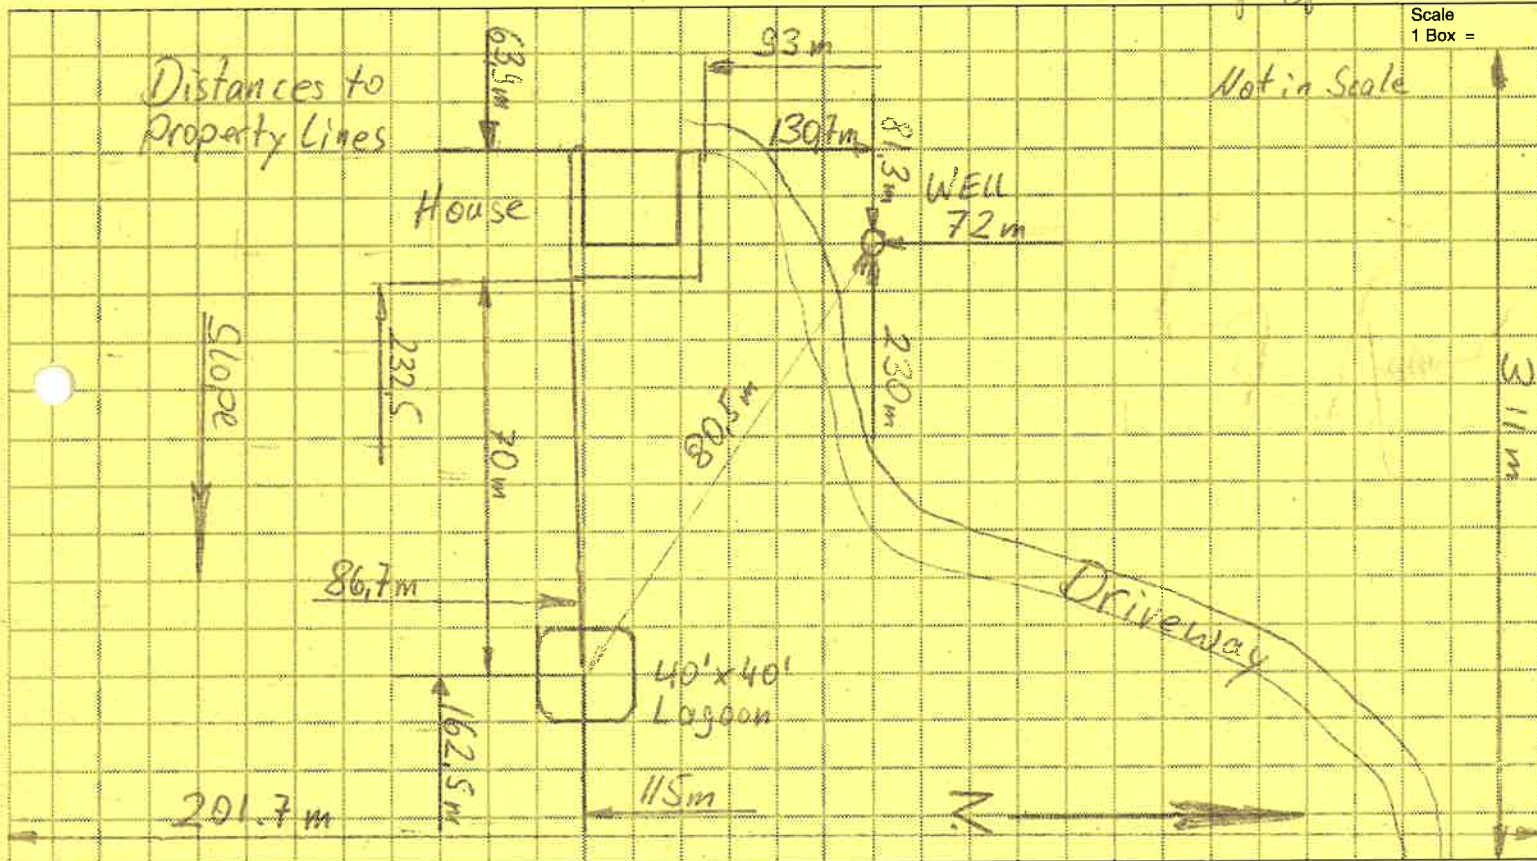

The Ministry of Health does not guarantee the useable life of the sewage disposal system. The life of the system is affected by the use and maintenance it receives. Pump out the septic tank every 2-3 years. For servicing of package treatment plants, consult your local service agent. For service guarantees, consult your local sewage disposal contractor. If the system needs repair or modification, a new permit is required.

This system is not authorized for backfilling and if corrections are required, a re-inspection fee of \$100 must be paid for each time the Public Health Inspector checks to see that the faults have been corrected.

DATE BACKFILL / USE AUTHORIZED <i>May 26, 2005</i>	SUBJECT TO THE FOLLOWING CONDITIONS:
<i>MAINTAIN PERIMETER AROUND LAGOON TO ALLOW MAXIMUM SUNLIGHT EXPOSURE & AERATION.</i> <i>TO BE FENCED TO A HEIGHT OF 4 FT. WITH A STURDY FENCING MATERIAL</i>	

SIGNATURE PUBLIC HEALTH INSPECTOR / EHO:

FOR PUBLIC HEALTH INSPECTOR / EHO USE ONLY

	APPROVED	REJECTED	NOT APPLICABLE		APPROVED	REJECTED	NOT APPLICABLE
septic tank	☐	☐	☒	curtain drain	☐	☐	☒
package treatment plant	☐	☐	☒	interceptor drains	☐	☐	☒
other (e.g. lagoon, holding tank) specify: <i>LAGOON 41'x47'</i>	☐	☐	☒	pump	☐	☐	☒
field laterals	☐	☐	☒	drain rock	☐	☐	☒
distribution box	☐	☐	☒	set back distances	☒	☐	☐
siphon	☐	☐	☒	fill	☐	☐	☒